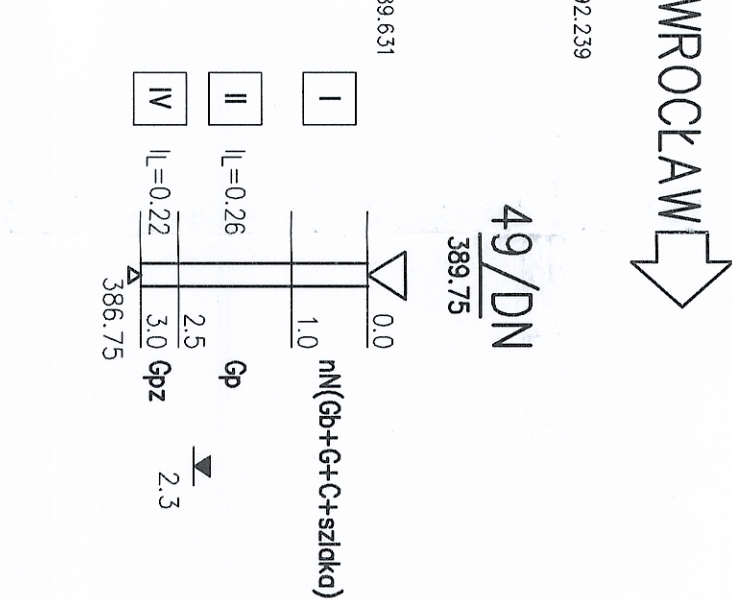
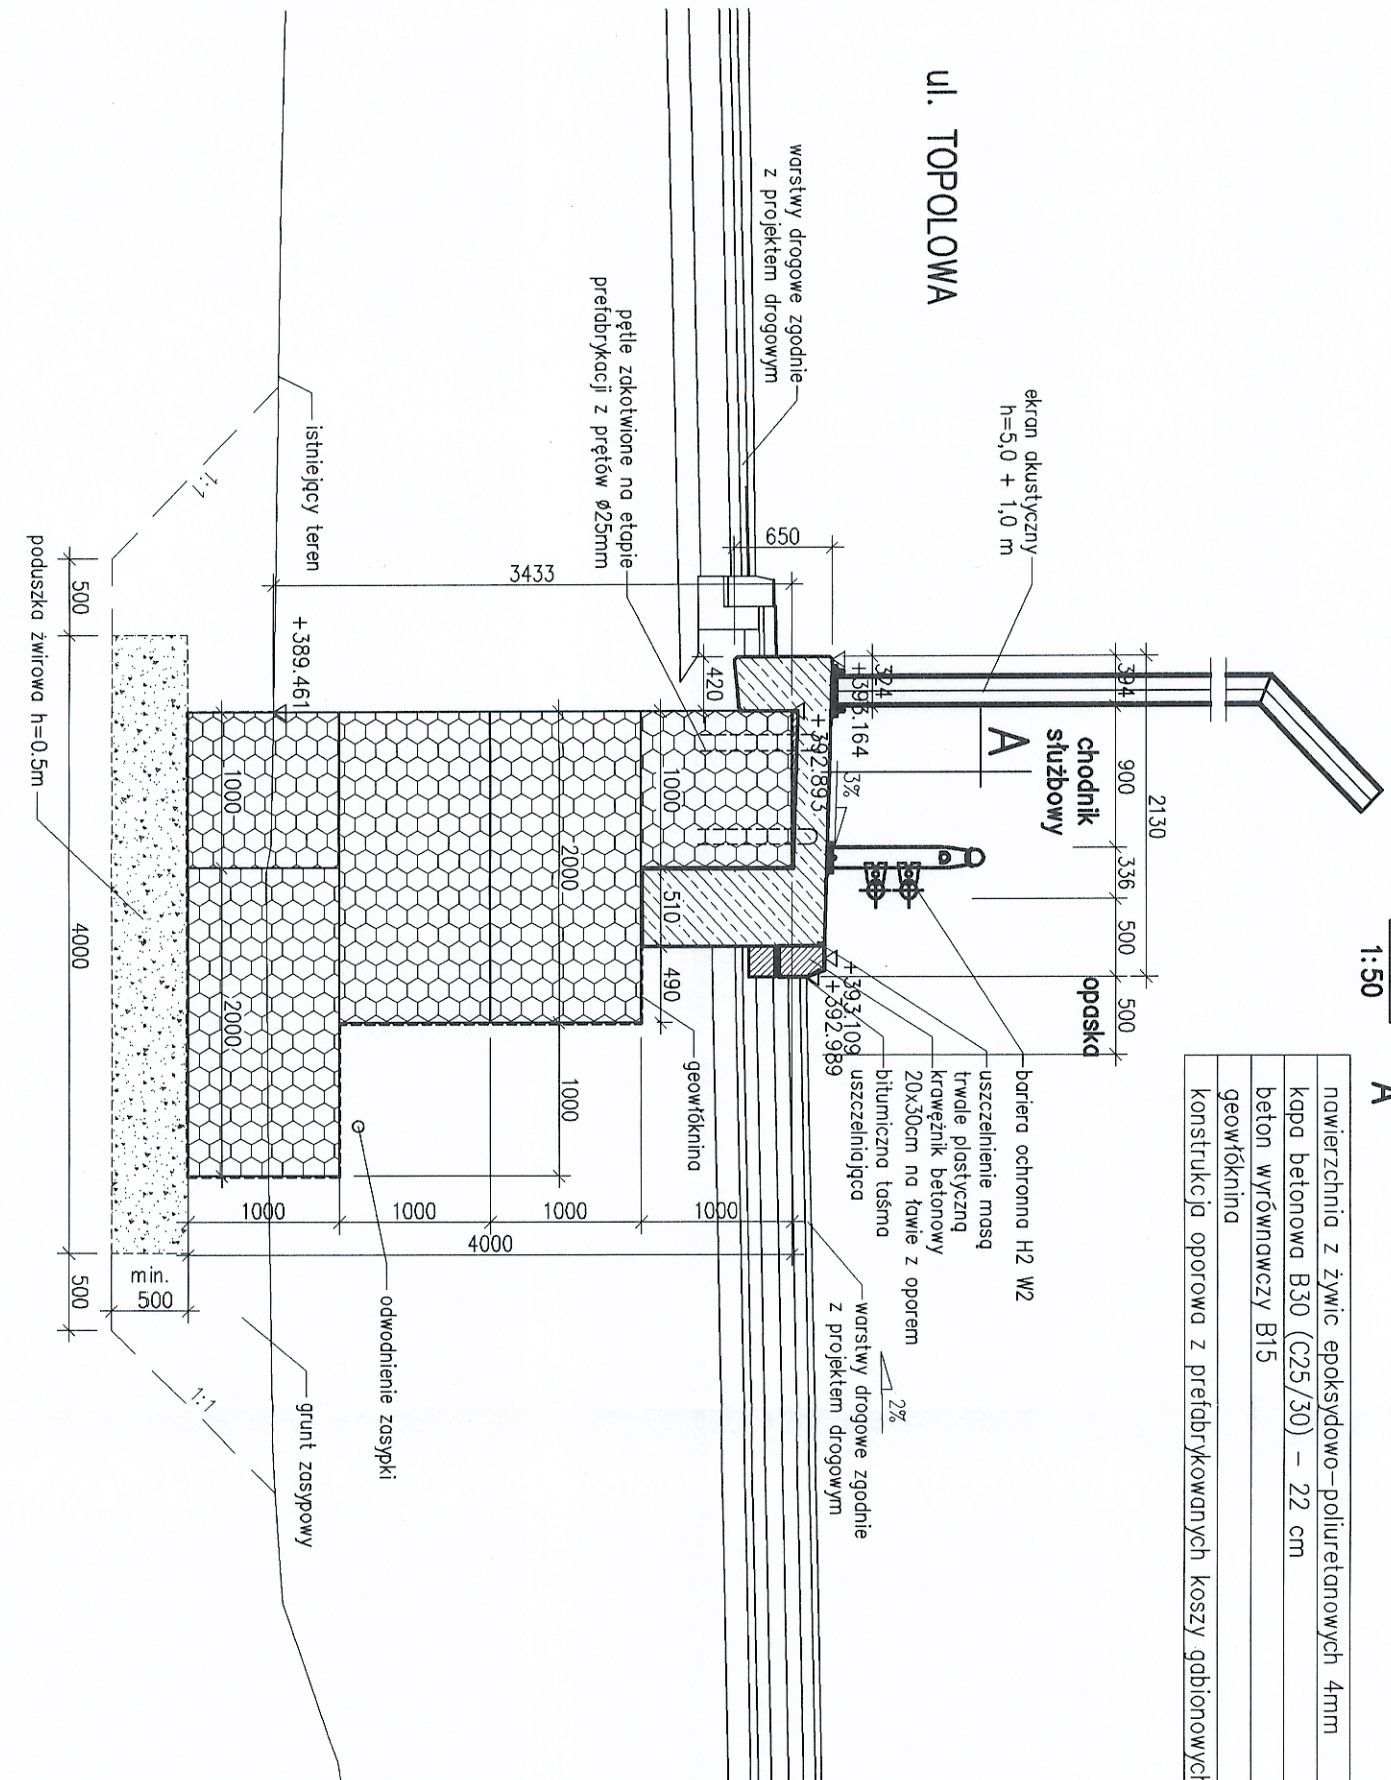
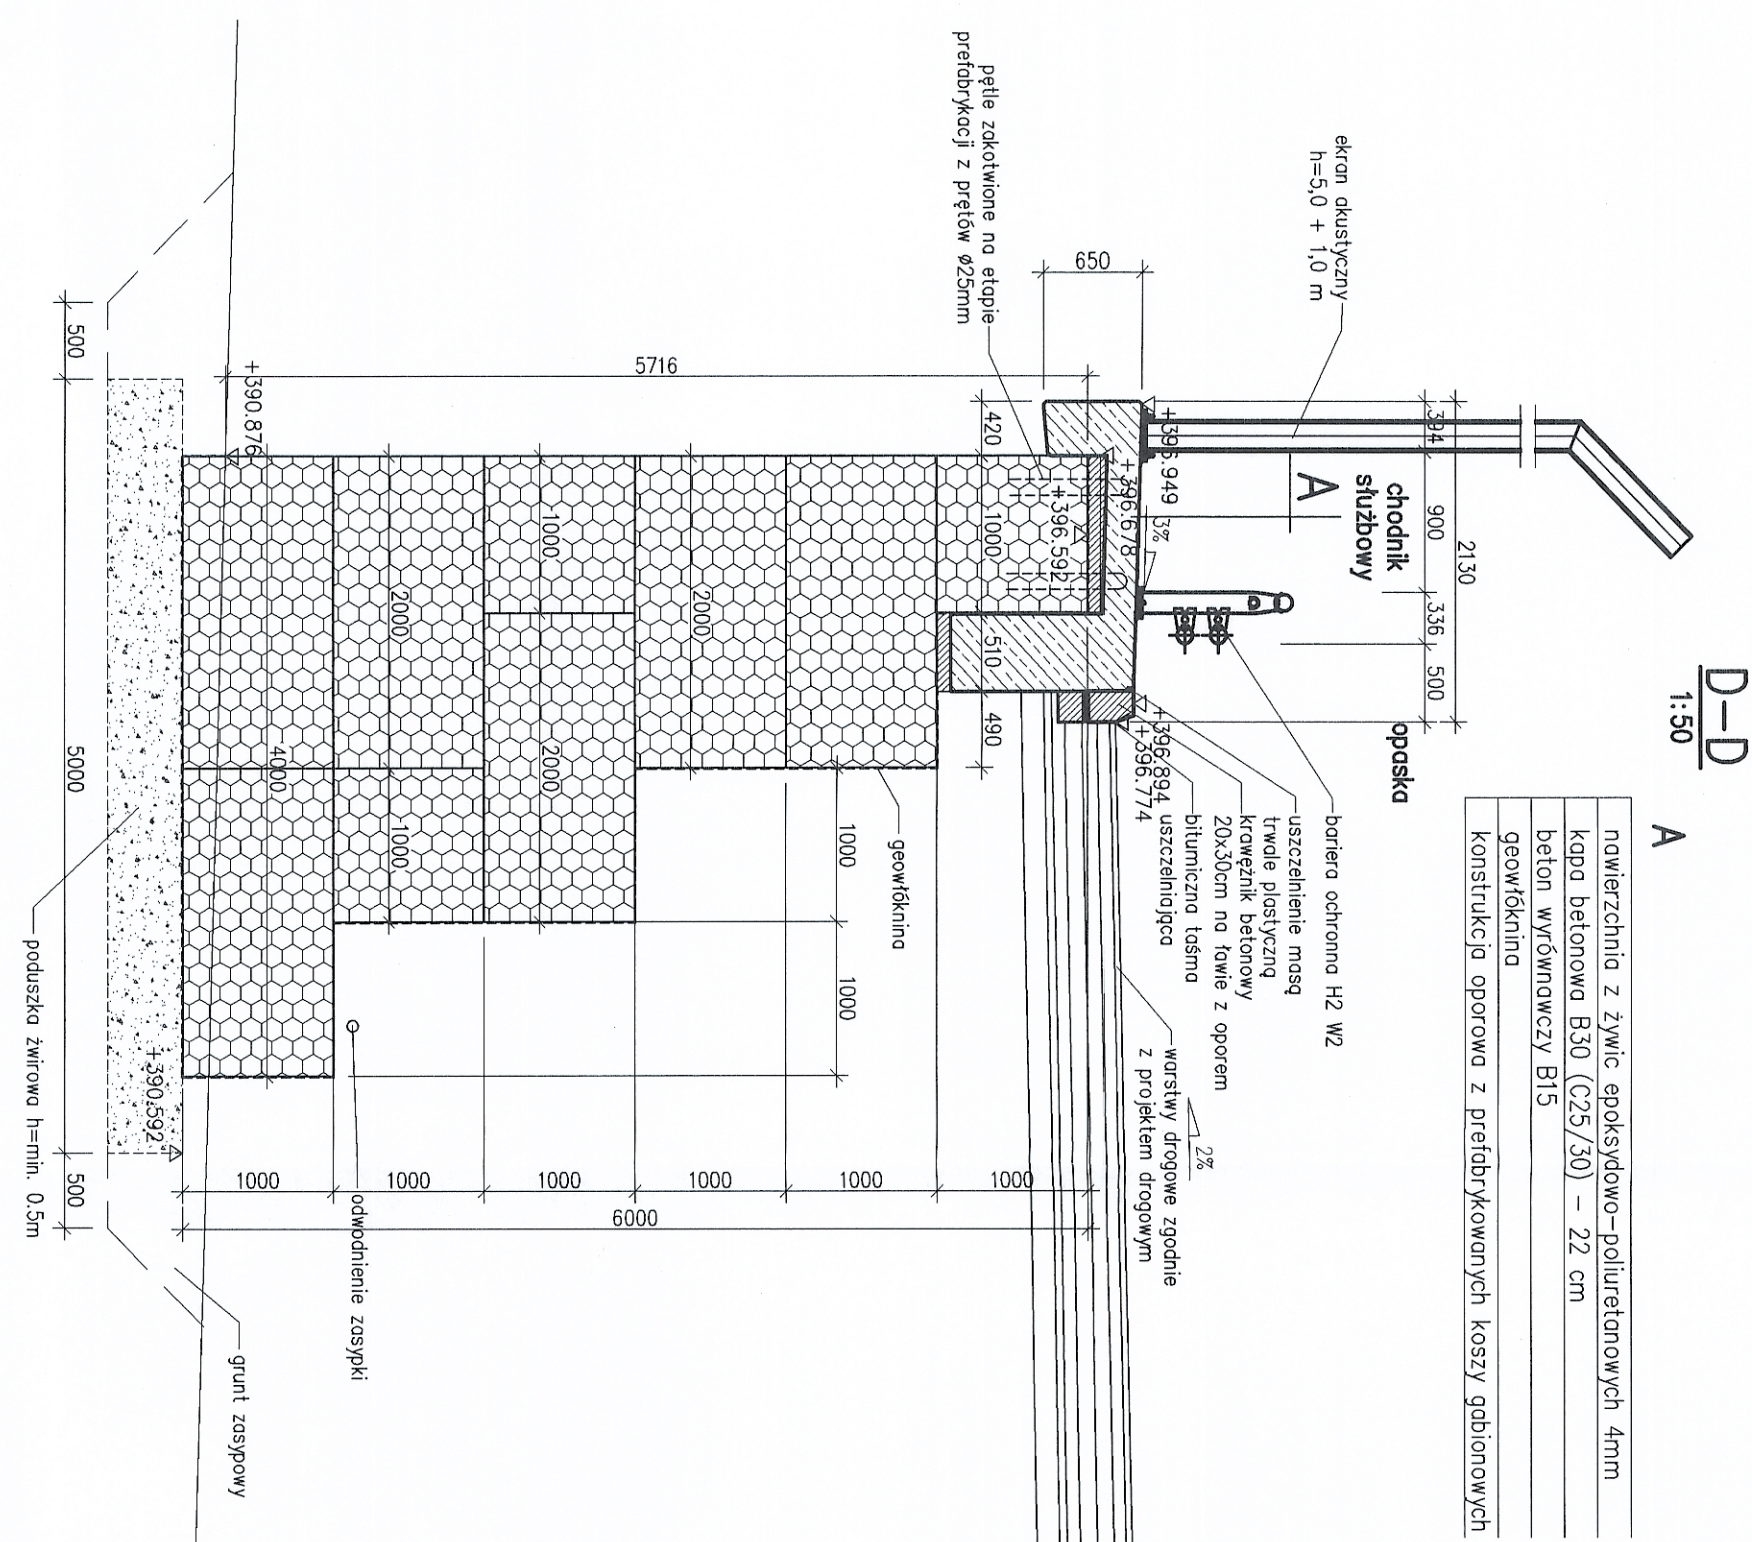


RZUT Z GOR
1:100

[illegible]