



Wrocław
DK-35

Mieroszów
DK-35

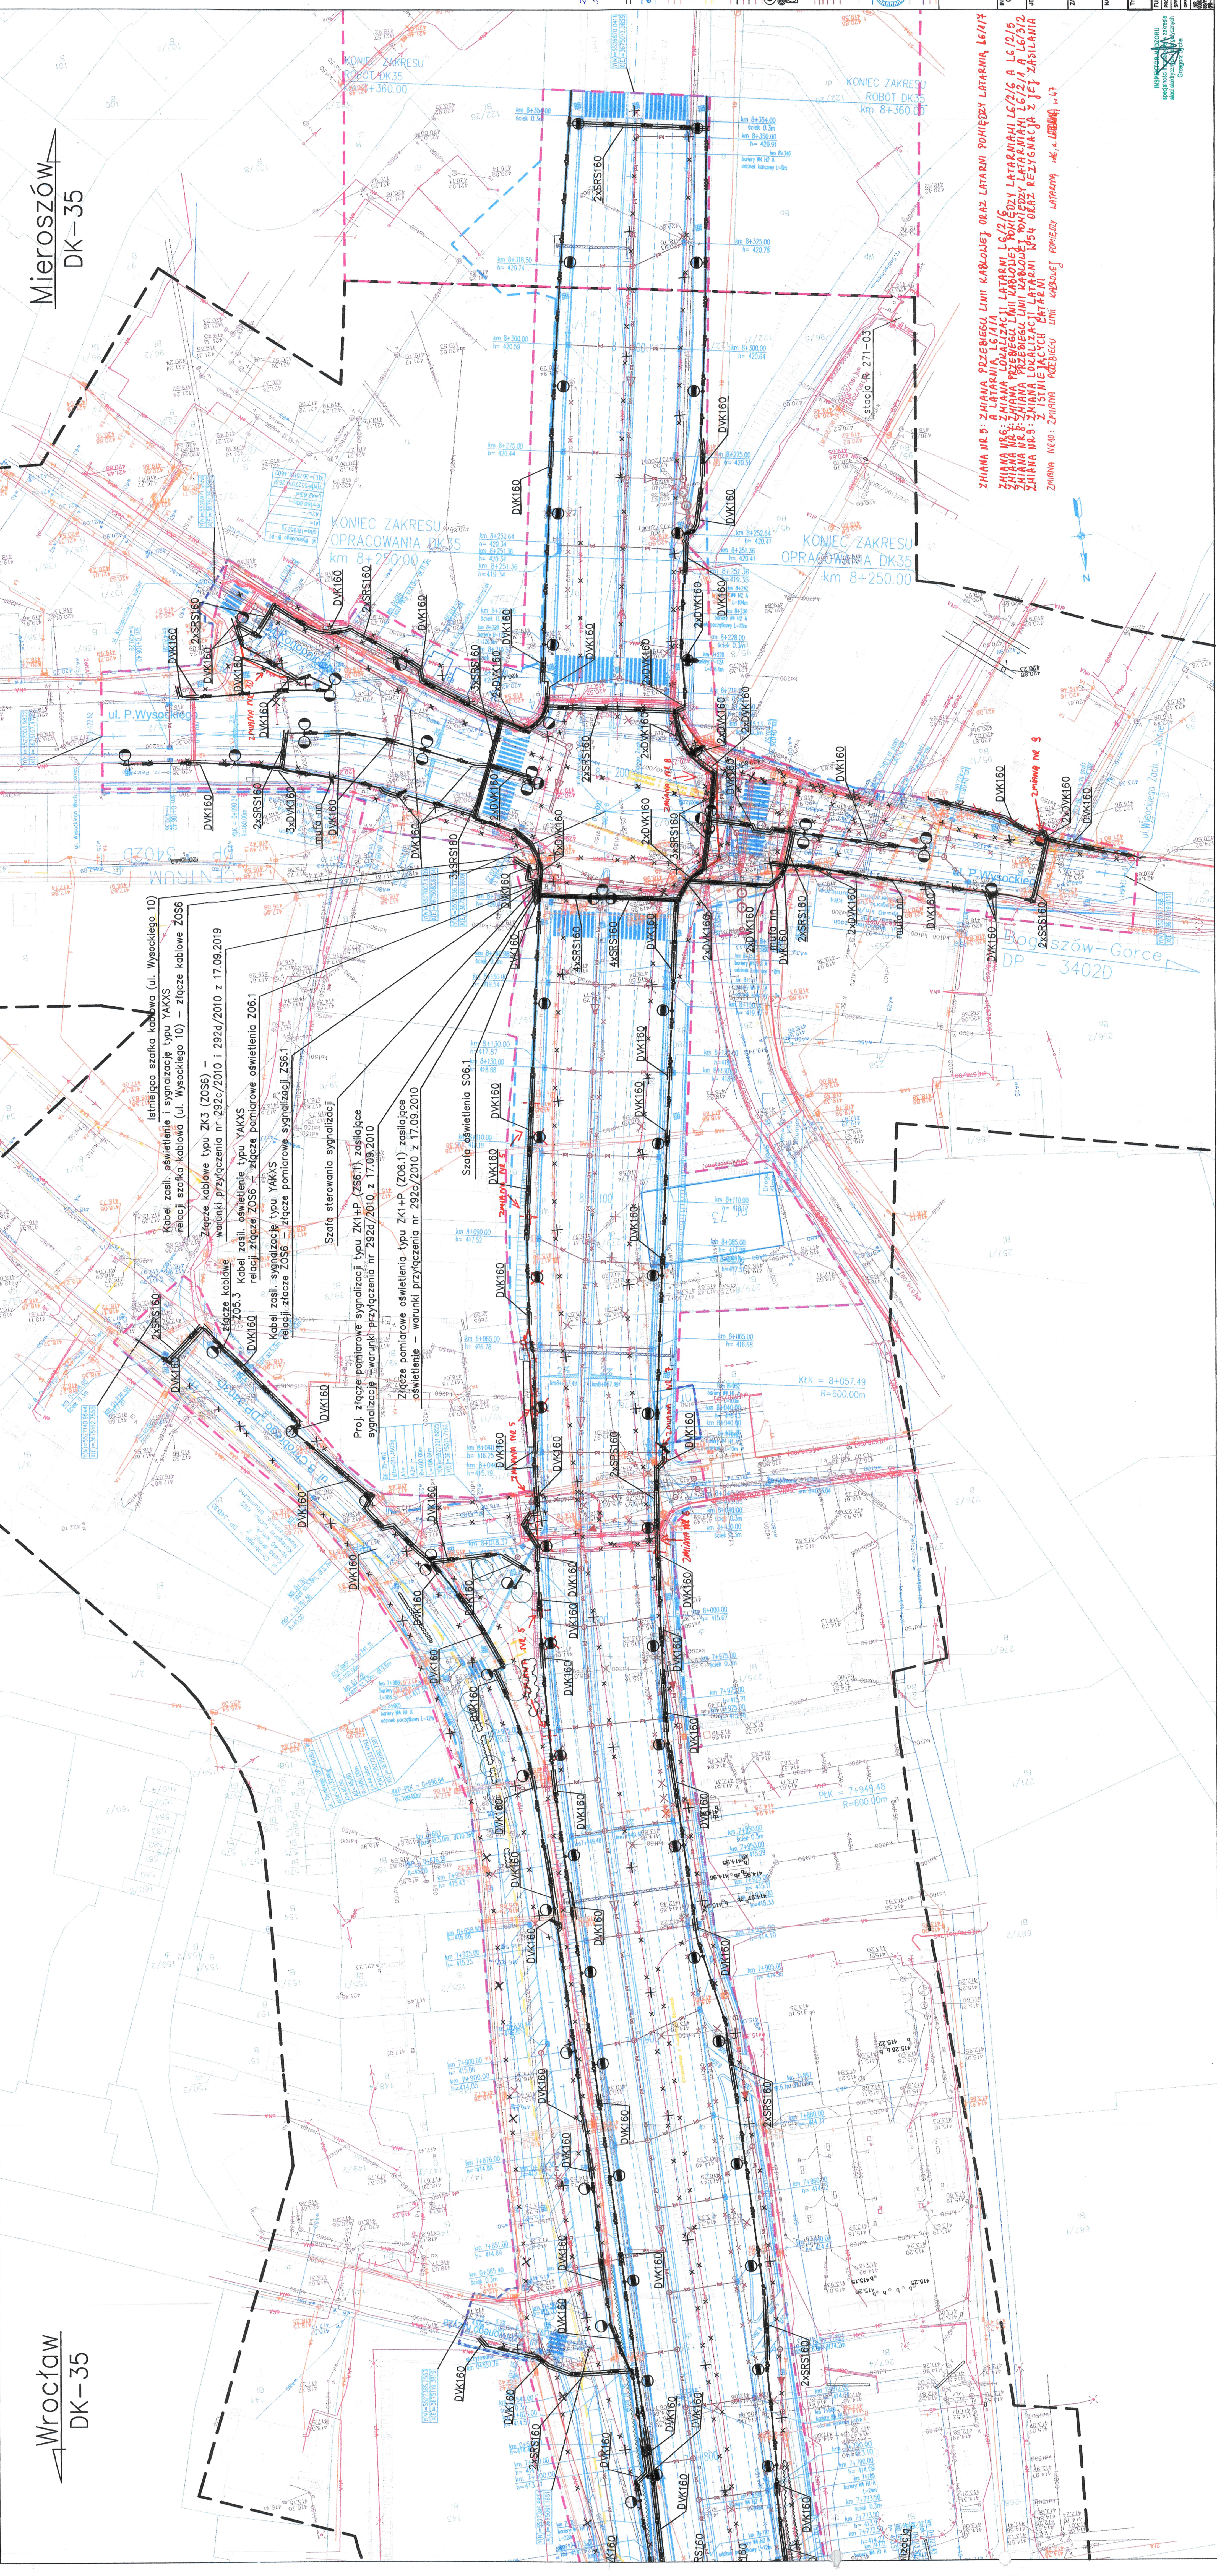

Wzrosty i-a starych mejszów
op. 1000 i 1000000

2010-2010
2010-2010

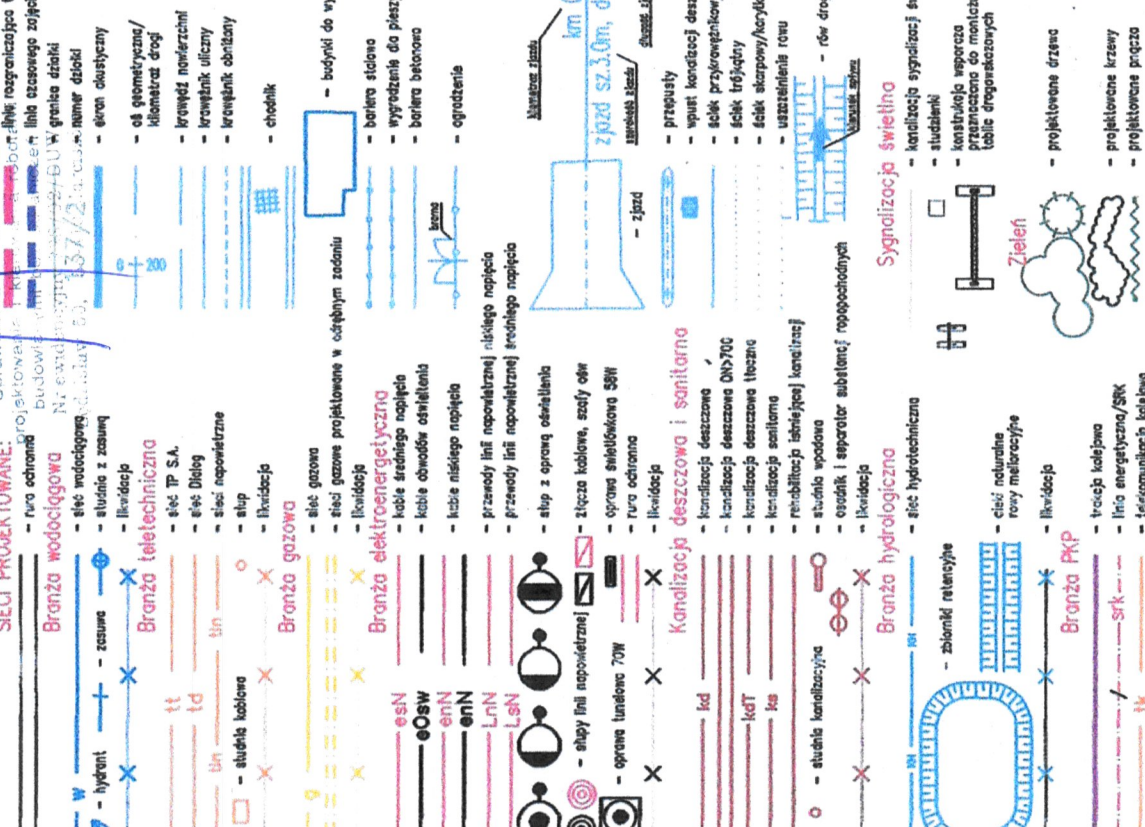

