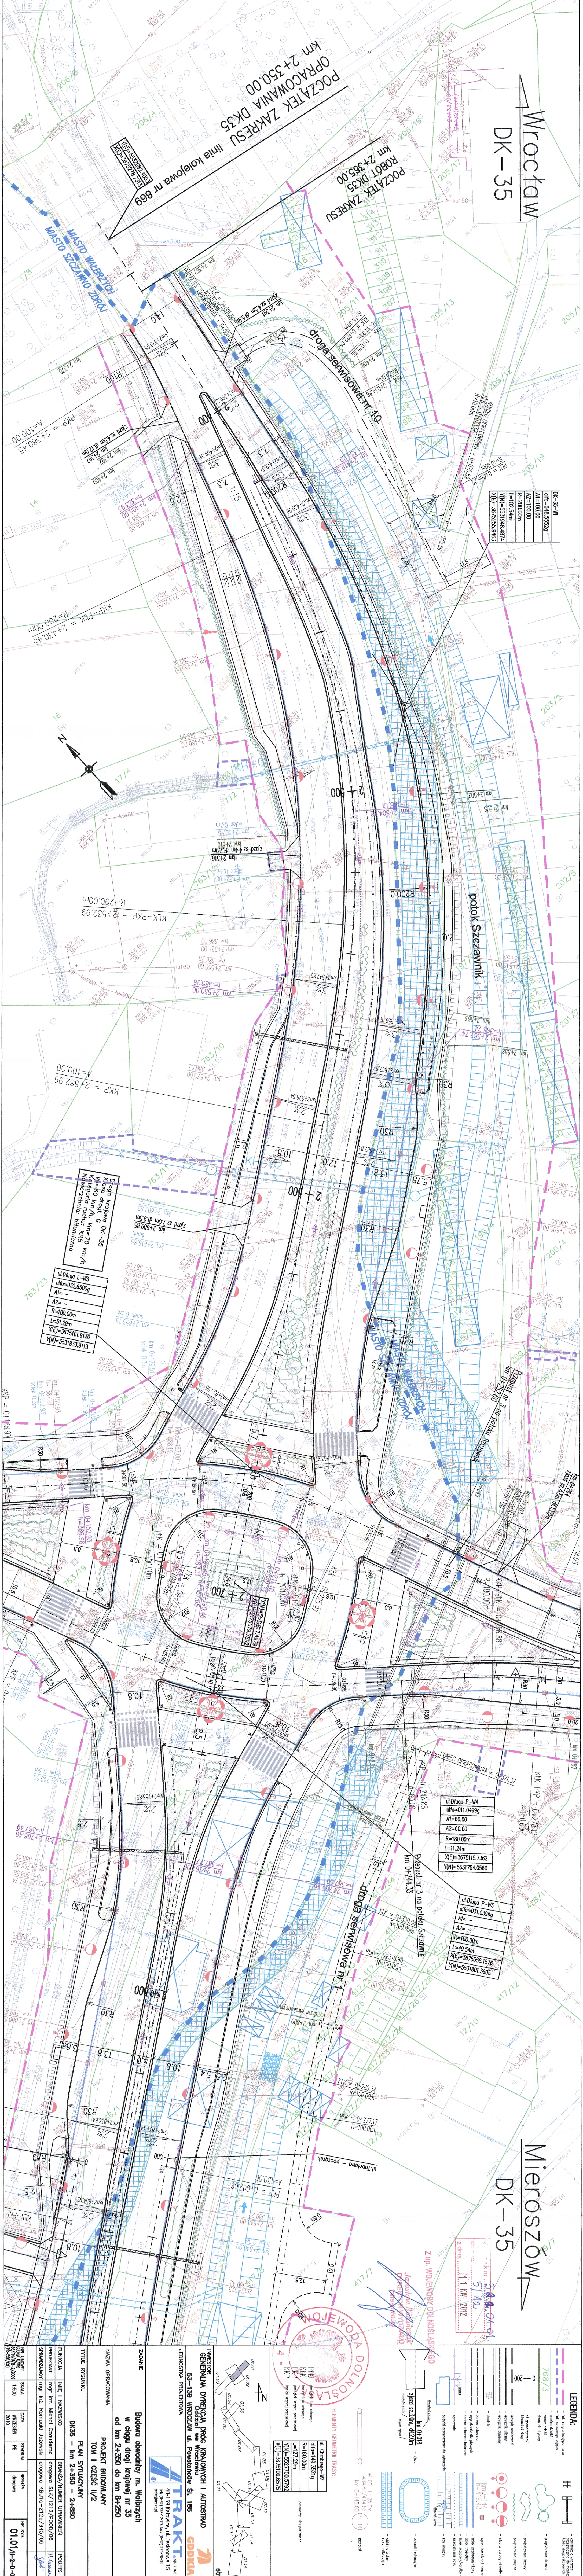


Mieroszów
DK-35

[illegible]