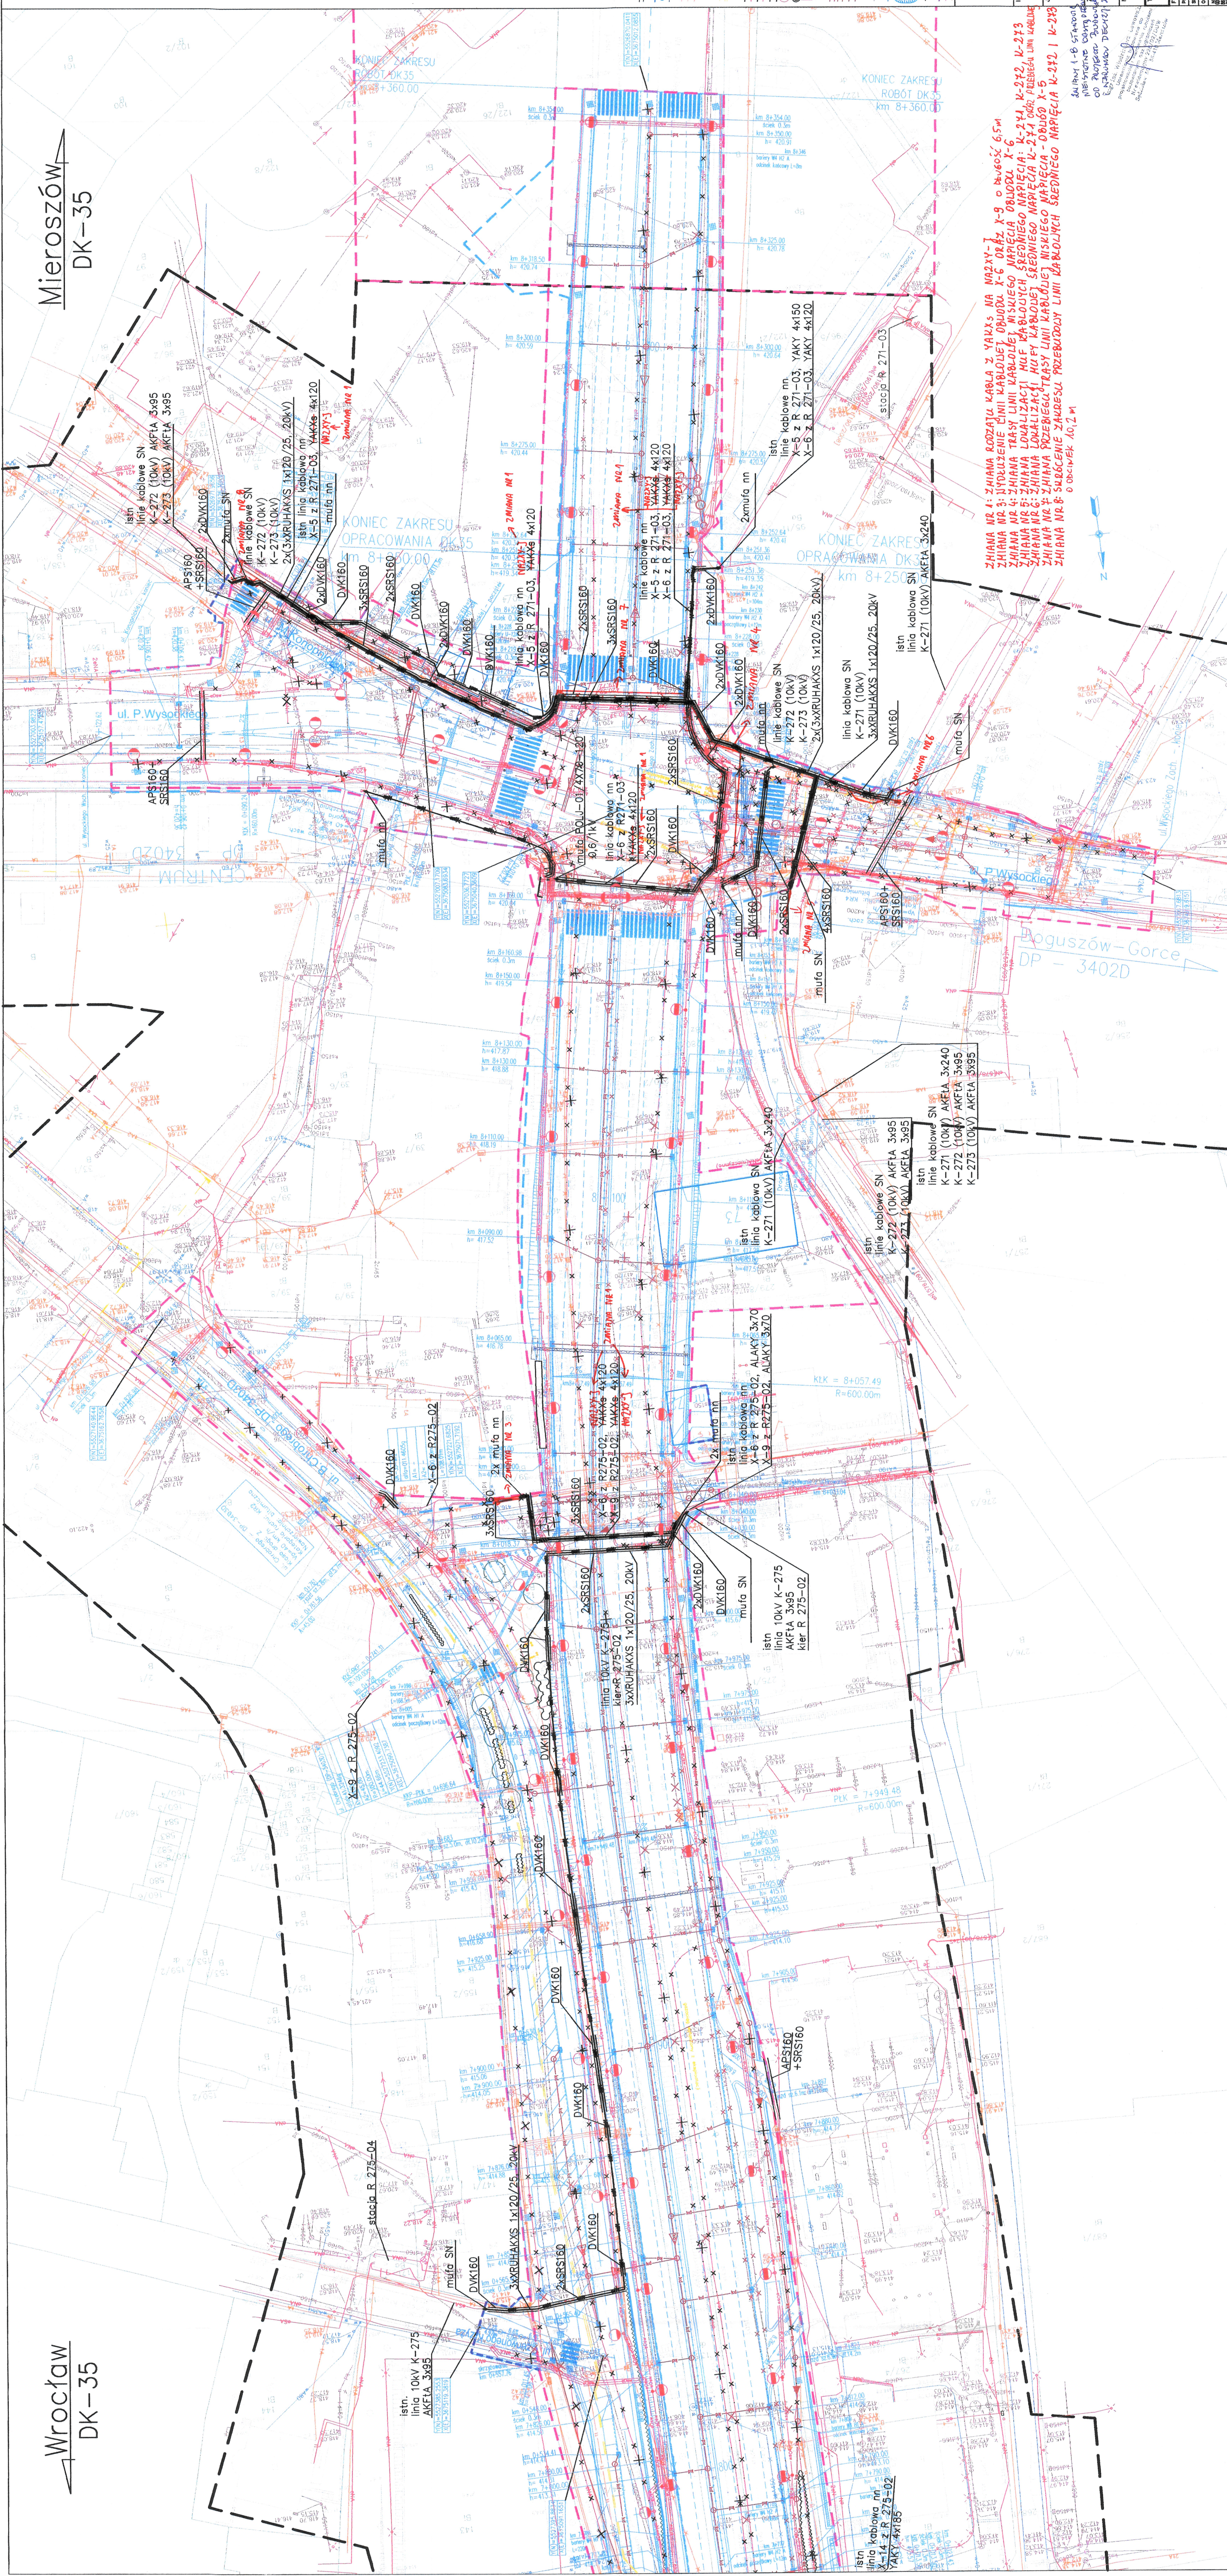


Mieroszków
DK-35

[illegible]