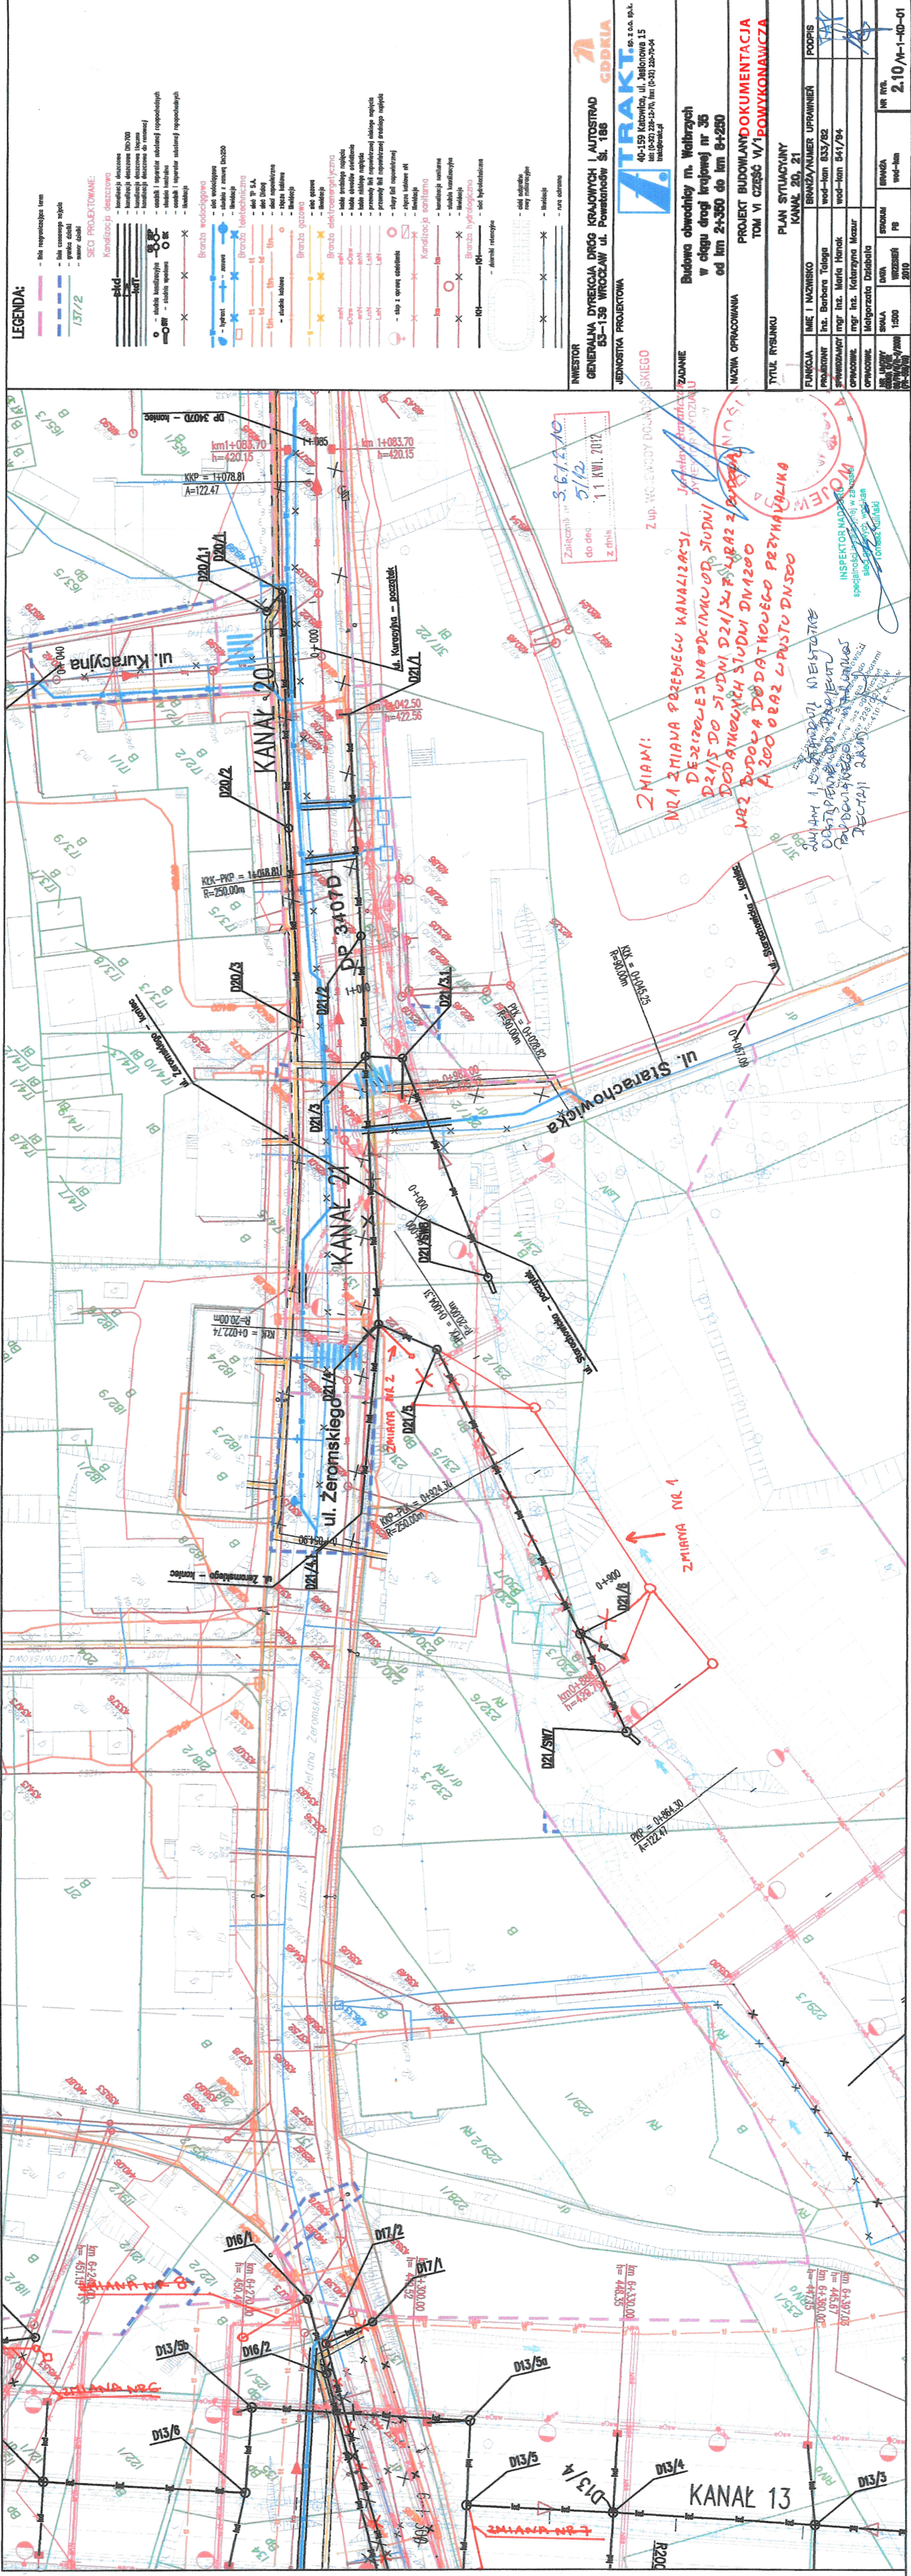


[illegible]